

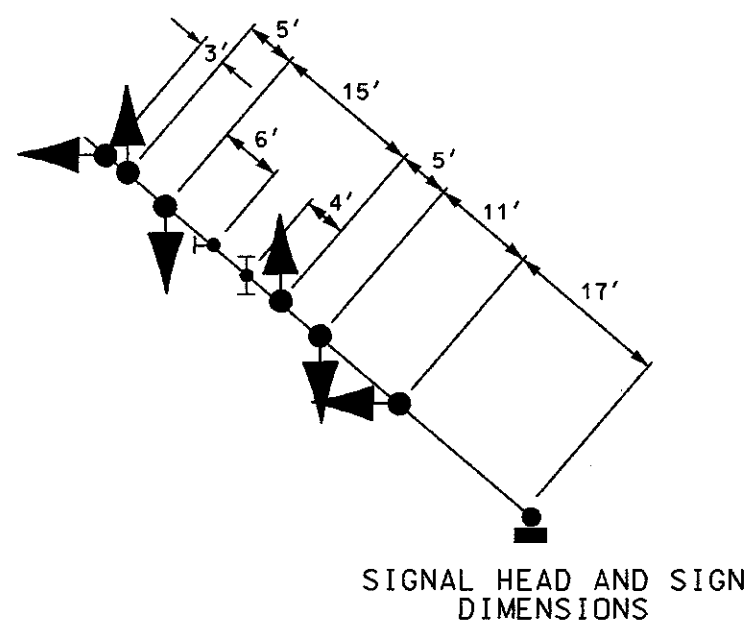



MD 378 IS ASSUMED TO RUN IN A NORTH-SOUTH DIRECTION

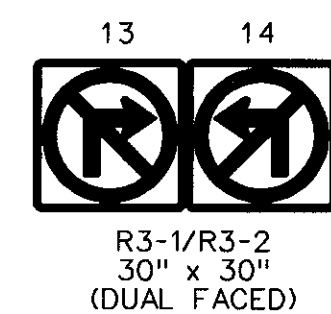


PROPOSED SIGNS

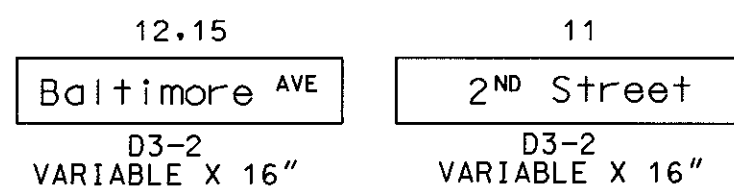


PROPOSED SIGNALS

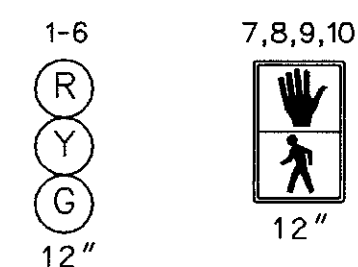

NEMA PHASING

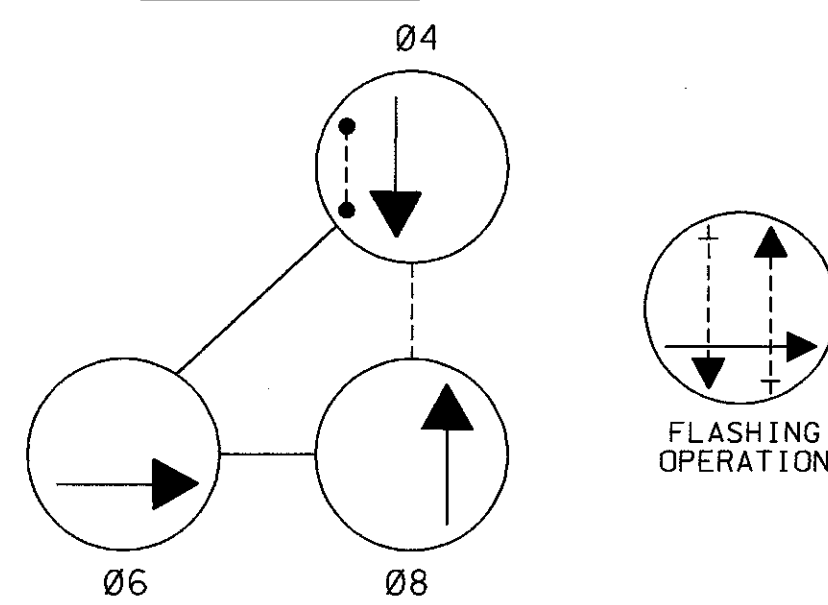


PHASING NOTES:
1. PHASES ASSOCIATED BY A DASHED LINE WILL OPERATE CONCURRENTLY.
2. PHASES ASSOCIATED BY A SOLID LINE WILL NOT OPERATE CONCURRENTLY.

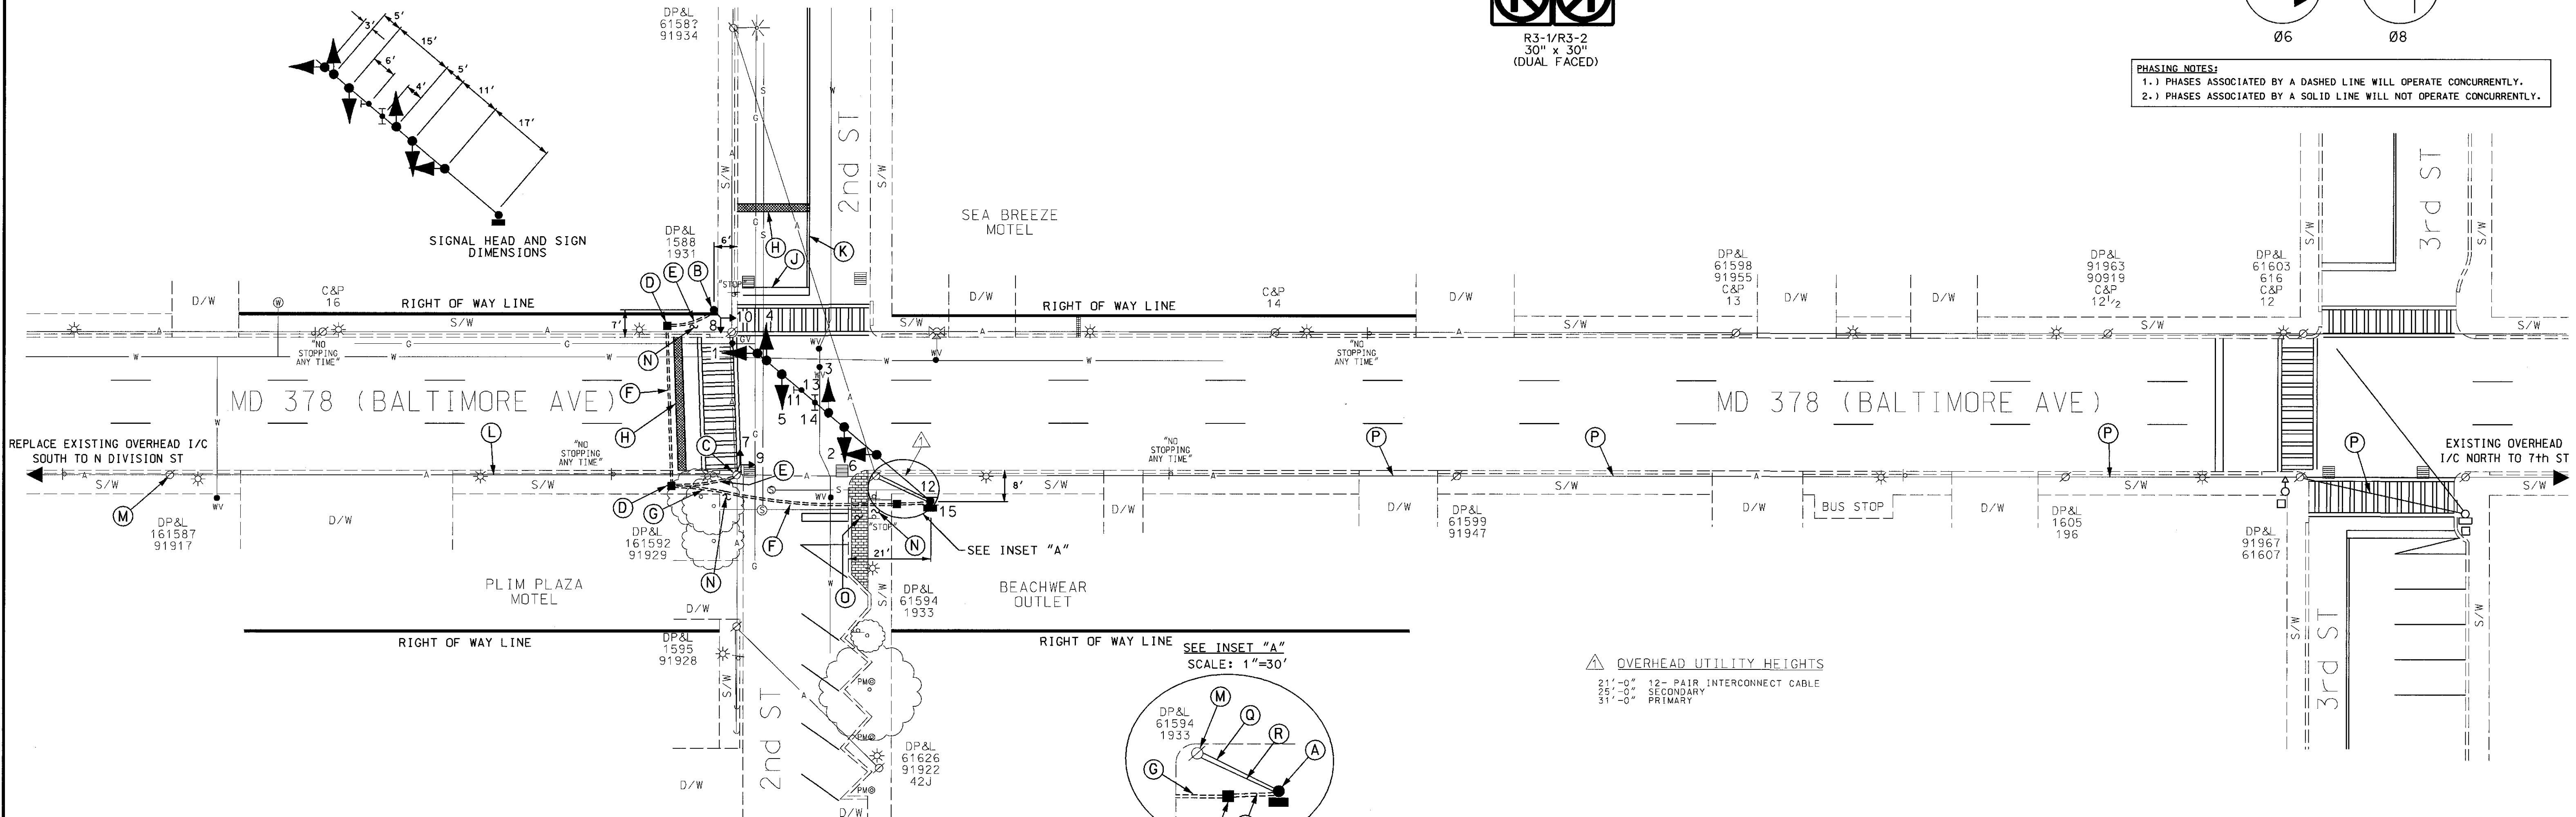

CONSTRUCTION DETAILS

- Install 27' steel pole (cut to 21') with a 60' mast arm, traffic signal heads, signs, 3" weatherhead, 3" blind coupling and NEMA size "5" pole-mounted cabinet and controller with control and distribution as shown. (Note: 1-3", 90°polyvinyl chloride (Schedule 80) bend.)
- Install 10' breakaway pedestal pole, pedestrian signal heads and pedestrian education sign as shown. (Note: 1-3", 90°polyvinyl chloride (Schedule 80) bend.)
- Install pedestrian signal heads with pedestrian education sign and 3" PVC riser onto existing utility pole as shown. (Note: 1-3", 90°polyvinyl chloride (Schedule 80) bend.)
- Install handhole.
- Install 3" polyvinyl chloride electrical conduit (Schedule 80) (trenched).
- Install 4" polyvinyl chloride electrical conduit (Schedule 80) (slotted).
- Install 4" polyvinyl chloride electrical conduit (Schedule 80) (trenched).
- Install 24 white, heat applied permanent preformed thermoplastic pavement marking (stopline).
- Remove existing pavement marking (stopline).
- Remove 20' of existing double yellow centerline pavement marking.
- Cut existing interconnect cable from approximately 70' south of 2nd Street and reroute to new controller. Install new overhead interconnect cable south to N. Division Street controller. (Note: Use existing thru bolts).
- Install 12-pair overhead interconnect cable. (Note: Use existing thru bolts).
- Remove existing sidewalk and replace after the installation of the signal equipment.
- Remove existing decorative brick sidewalk and replace after the installation of the signal equipment.
- Existing overhead interconnect cable
- Install 12-pair overhead interconnect cable.
- Proposed overhead electrical service to be installed by Conectiv.

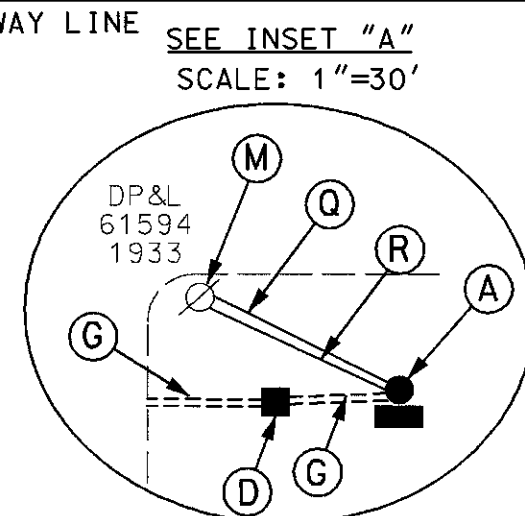

OVERHEAD UTILITY HEIGHTS
21'-0" 12-PAIR INTERCONNECT CABLE
25'-0" SECONDARY
31'-0" PRIMARY

GENERAL NOTES:

- This plan reflects only those underground utilities that were apparent at the time of this location being asbuilt. A detailed review was not undertaken and this plan should not be construed as representing all underground utilities in the area.
- Any modification to this subject signal should be preceded by a thorough identification of all existing utilities.
- Unless otherwise noted the right of way line is assumed to be at the back edge of the sidewalk.
- All pavement markings detailed are proposed and are to be installed in accordance with SHA standards.

GEOMETRIC LEGEND	
PROPOSED	---
EXISTING	---
LEGEND OF UNDERGROUND AND OVERHEAD UTILITIES	
AERIAL CABLE	---
ELECTRIC	---
TELEPHONE	---
GAS	---
SEWER	---
WATER	---
CABLE TV	---

STREET TRAFFIC STUDIES, LTD.
400 Crain Hwy. NW
Burrhead, MD 20686
Ph (410) 590-5500
Fax (410) 590-6637

REVISIONS	APPROVALS
	<i>[Signature]</i> CHIEF, TRAFFIC ENGINEERING DESIGN DIVISION
	<i>[Signature]</i> ASST. CHIEF, TRAFFIC ENGINEERING DESIGN DIVISION
	<i>[Signature]</i> DIRECTOR, TRAFFIC & SAFETY

MARYLAND DOT - STATE HIGHWAY ADMINISTRATION
Office of Traffic & Safety
TRAFFIC ENGINEERING DESIGN DIVISION
MD 378 (BALTIMORE AVE) AND 2nd STREET

DRAWN BY: WJ NIES	F.A.P. NO.	TS NO.	SHEET NO.
CHECKED BY: RR ZACHERL	S.H.A. NO.	4200	1 OF 2
SCALE: 1"= 20'	COUNTY: WORCESTER	T.I.M.S. NO. F358	
DATE: 8-20-02	LOG MILE: 230378.00, 54		